


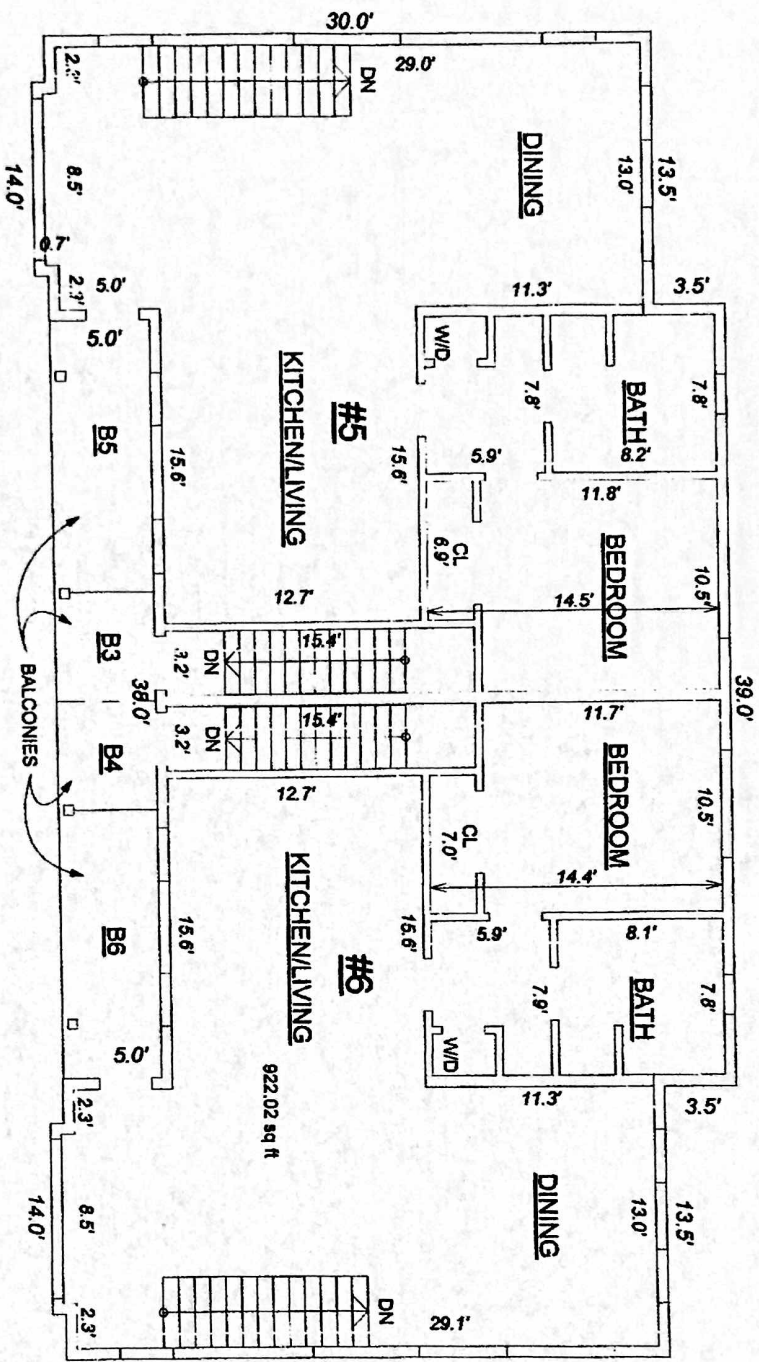

UNLADDED AREA INDICATES UNIT 6


UNIT 6 - THIRD FLOOR PLAN



Floor Plan Certification
 I certify that this plan fully and accurately depicts the layout, location, unit numbers and dimensions of the units in the 21 Kennebec Condominium as built

MOC
 Maurice L. O'Connor, Registered Architect

12/11/06
 Date

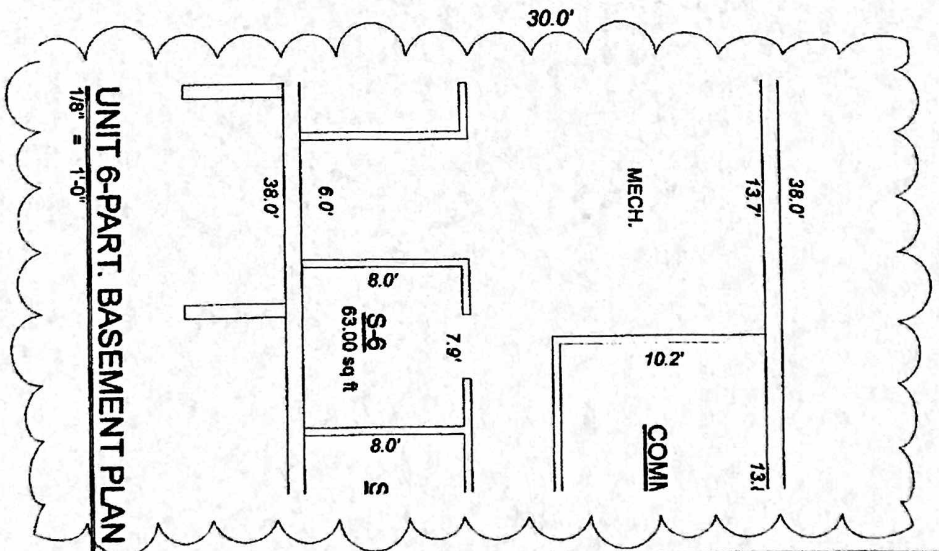

UNIT 6 PART. BASEMENT PLAN

1/8" = 1'-0"

<p>UNIT 6</p>	<p>DATE: 11 DEC 01</p>	<p>SCALE: 1/8" = 1'-0"</p>	<p>DRAWING #</p>	<p>21 KENNEBEC AVENUE OAK BLUFFS, MA</p>	<p>sullivan o'connor architects p.o. box 985 oak bluffs, ma 02557 ph: 508.444.6202 fax: 508.451.1121 www.sullivanocconnorarchitects.com</p>
	<p>MOCC</p>	<p>DRAWING BY</p>	<p>SHEET TITLE</p>	<p>UNLADDED AREA INDICATES UNIT 6</p>	