No. 10-54

COMMONWEALTH OF MASSACHUSETTS

Board of Health, OAK BLOFFS, MA




APPLICATION FOR DISPOSAL SYSTEM CONSTRUCTION TERMIOF HEALTH

Location #312 EAST CHOP DRIVE	Owner's Name DANIEL HOLAN
Map/Parcel# 1-59	Address of VINEYARD LAND SURVEYING + ENG INC.
Lot#	Telephone# #12 COURNOYER ROAD P.O. Box 421
Installer's Name	Designer's Name WEST TISBURY, MA 02575
Address	Address
Telephone#	Telephone# (508) - 693 - 3774
The Charles PESION I	
Type of Building No. of Redwoods (2) THEFE	Lot Size
	No. of persons Showers (), Cafeteria ()
Other Fixtures	no. or persons showers (), cateleria ()
ODDITUR.	ed design flow 330 Design flow provided 333 gpd
	Revision Date
	EXISTING TWO BEDROOM HOUSE AND DETRCHED BEDROOM
Description of Soil(s) SEE FORM	
Soil Evaluator Form No Name of Soil Eva	aluator R. SILVA Date of Evaluation 8/4/10
	01,
DESCRIPTION OF REPAIRS OR ALTERATIONS	Coastor
	1 1 1 1 1 1 1 1 1 1 1 1 1 1 1 1 1 1 1
No COMMONWEALTE	H OF MASSACHUSETTS
Board of Health, OA	k BLUFFS , MA.
CERTIFICATE	OF COMPLIANCE
Description of Work: ☐ Individual Component(s) ☐ Comple	A SOLIT TOOLS TO THE STANDARD STANDARD SALES AND SALES A
The undersigned hereby certify that the Sewage Disposal System;	•
by: DANIEL HOGAN	
at #312 EAST CHOP DRIVE (1-59)	
has been installed in accordance with the provisions of 310 CMR	R 15.00 (Title 5) and the approved design plans/as-built plans relating to
application No. $10-54$, dated $12-14-10$. Approximateller $12-14-10$.	Sved Design Flow(gpd)
Designer: VLSE Inspector:	
The issuance of this permit shall not be construed as a guarantee	
*************************************	de conserve escape en
No	FEE 250.00
COMMONWEALTI	H OF MASSACHUSETTS
	AK BLUFFS, MA. Vis Enginee
	CONSTRUCTION PERMIT
	Upgrade(X) Abandon() an individual sewage disposal system
at # 312 FAST CHOP DRIVE (1-59)	as described in the application for
Disposal System Construction Permit No/	
Frovided: Construction shall be completed within three ye	ears of the date of this permit. All local conditions must be met.

Date 5-24-// Board of Health _

Form 1255 Rev. 5/96 A.M. Sulkin Co. Charlestown, MA

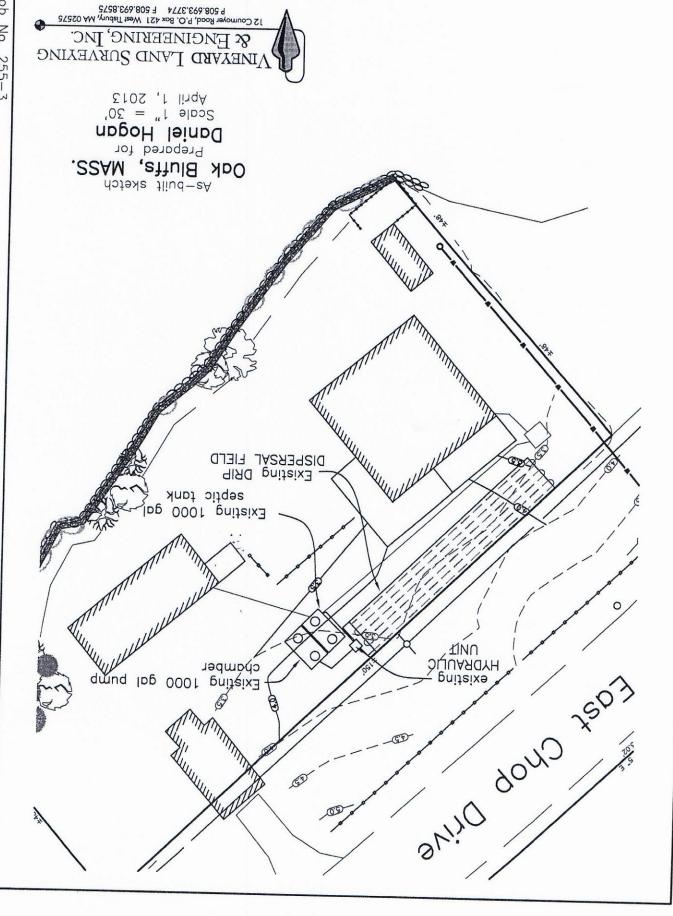

Job No. 255-3