




TOWN OF WEST TISBURY

BOARD OF HEALTH

TELEPHONE 693-6395
P.O. BOX 278
WEST TISBURY, MA 02575

SEPTIC INSTALLER'S AS BUILT DRAWING

MAP 11 PARCEL 36 ADDRESS 496 Lambert's Cove Rd.
OWNER Mark + Catherine Peters
PERMIT NO. _____ ENGINEER Savati Engineering ☒ NEW ☐ REPAIR
INSTALLER Mark V. Peters M.V.P. Excavation + Septic DATE 4-1-2021
COORDINATE DIAGRAM Pond (Include wells, water & powerlines & fuel storage tanks)

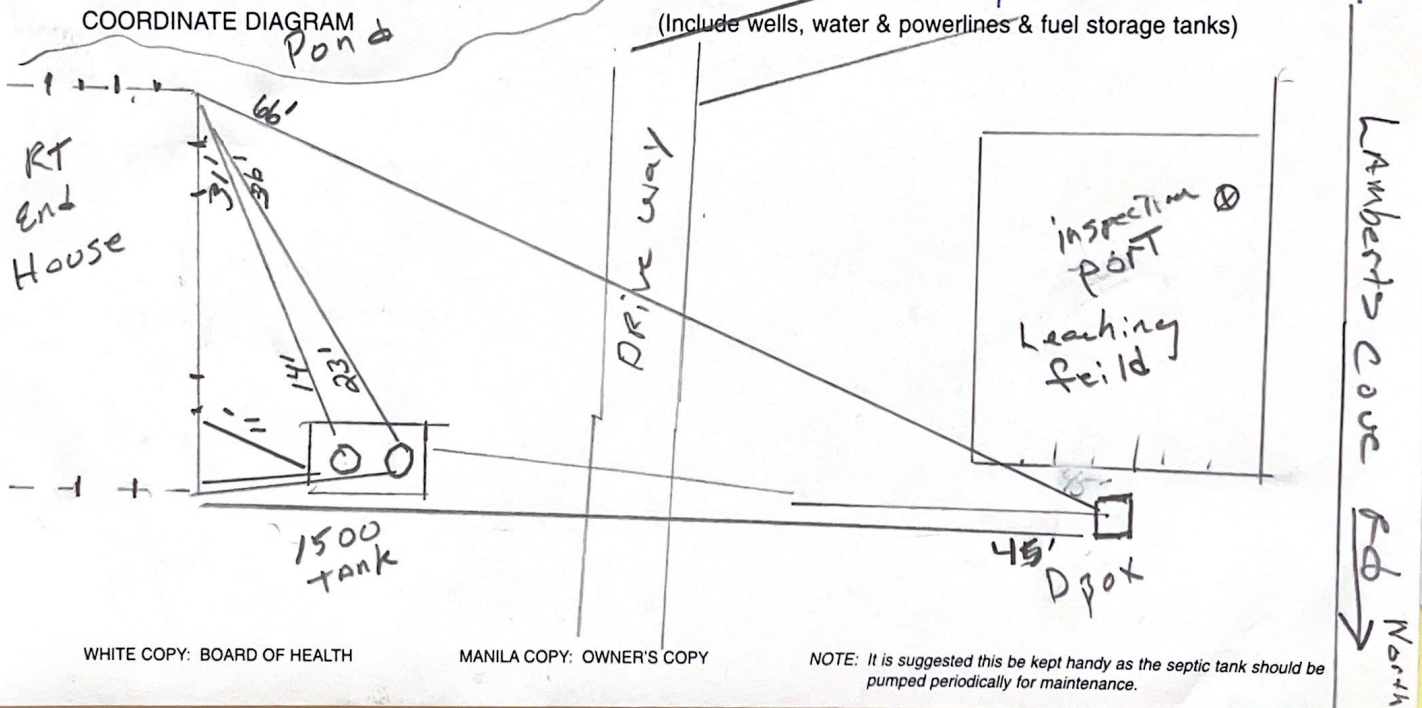

WHITE COPY: BOARD OF HEALTH

MANILA COPY: OWNER'S COPY

NOTE: It is suggested this be kept handy as the septic tank should be pumped periodically for maintenance.