



TEST HOLE DATA

#1 3/23/94 0-1' W. LOAM 1-3' CLAYEY SAND 3-9' WHITE SAND w/TR. CLAY DRY	#2 3/27/94 0-1' W. LOAM 1-3' CLAYEY SAND 3-10' SAND w/TR. CLAY K=30 F/D DRY
#3 3/25/94 0-5' CLAYEY SAND 5-11' MED SAND w/TR. CLAY SEDS @ 5' DRY AT BOTTOM	#4 3/25/94 0-1/2' W. LOAM 1/2-5' SILTY SAND 5-12' MED SAND w/TR. CLAY SEDS @ 5' SET 4" PVC DRY
#5 3/25/94 0-1/2' W. LOAM 1/2-5' CLAYEY SAND 5-11' MED SAND K=30 F/D DRY PR 4MPI	

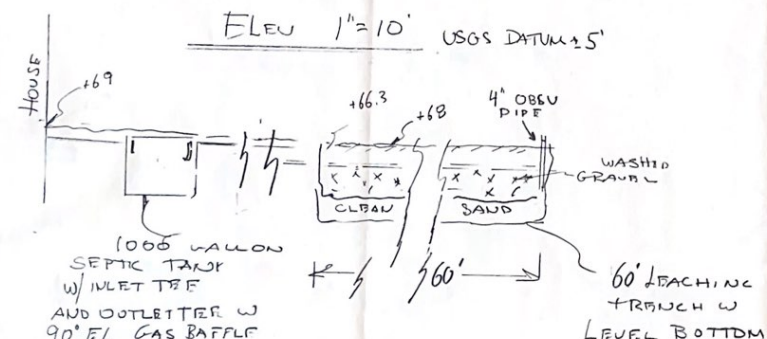

TRENCH X-SECTION 1"=4'

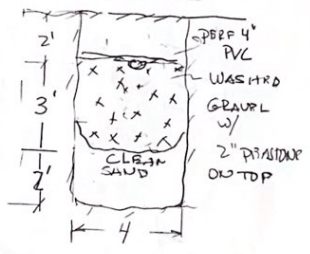

DESIGN DATA

- 4 - BEDROOMS - 440 GPD
- 60' x 3' x 4' LEACHING TRENCH PR_{DES} = 6 MPI
 SIDE: 360 F² x 1.66 GPD/F² = 599 GPD
 BOTTOM: 240 F² x .71 " 17053 " 553 GPD
 770 GPD

AS BUILT 10-29-94

WASTE WATER TREATMENT SYSTEM FOR
 MICHAEL & PAULA BLACK
 PARCEL 114 MAP 32
 OFF SOUTH ROAD
 WEST TISBURY MASS.
 11-27-94
 KENT A. HEALY 4/12/94
 WEST TISBURY MASS
 P.E. MASS # 28498