


- Dimensions  
1-A=15.5'  
2-A=28.4'  
1-B=18.2'  
2-B=21.9'  
2-C=20.4'  
3-C=35.9'  
2-D=29.2'  
3-D=32.8'  
2-E=39.5'  
3-E=33.0'

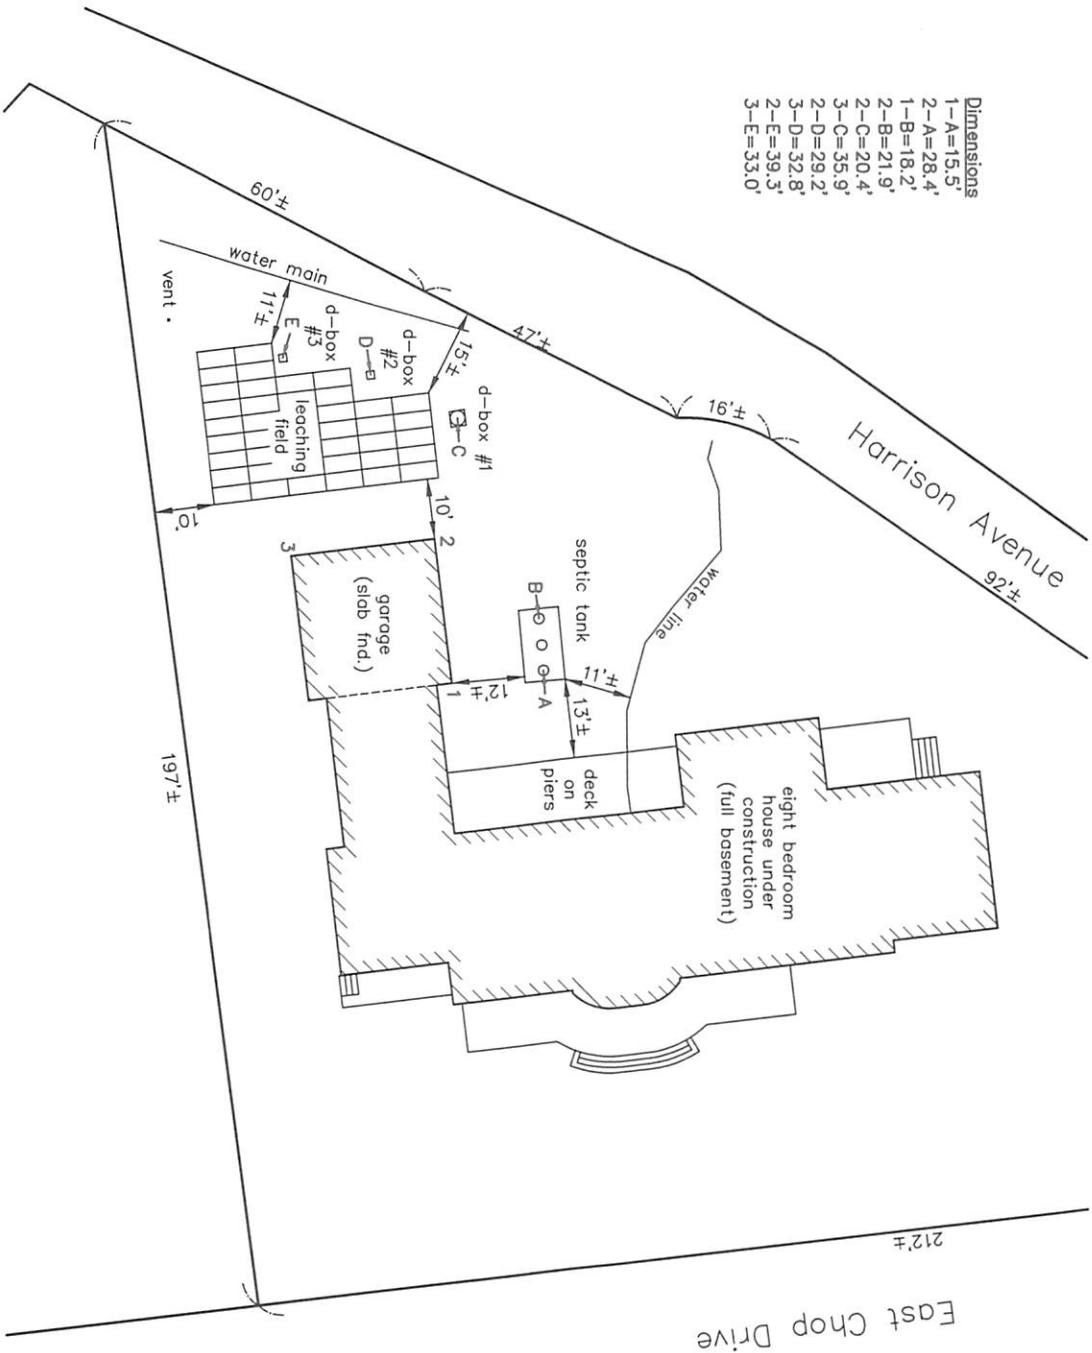

East Chop Drive

RECEIVED  
JUN 08 2018  
OB BD OF HEALTH

OBBD OF HEALTH

### As Built Sketch

*Oak Bluffs, Massachusetts*

Assessor Parcel 2-48

*prepared for*

*Paul Massey &  
Gretchen Massey*

*Scale 1"=20' February 14, 2018*

Scale 1"=20' February 14, 2018



*P.O. Box 4458  
107 Beach Road, Suite 202  
Vineyard Haven, MA 02568  
Phone (508) 693-9933 Fax (508) 693-4933*

Job No. 101578

No. REV 16-46

THE COMMONWEALTH OF MASSACHUSETTS

FEE 100.00

## BOARD OF HEALTH

Town Oak Bluffs OF Oak Bluffs**PAID**  
6441

## APPLICATION FOR DISPOSAL SYSTEM CONSTRUCTION PERMIT

Application for a Permit to Construct ☒ Repair ( ) Upgrade ( ) Abandon ( ) - ☒ Complete System ☐ Individual Components

<u>150 East Chop Drive</u> Location	<u>Paul &amp; Gretchen Massey</u> Owner's Name
<u>Map 2, Parcel 48</u> Map/Parcel #	<u>76 Shore Drive</u> Address
<u>Richard Olson &amp; Son</u> Installer's Name	<u>Larchmont, NY 10538-3834</u> Telephone #
<u></u> Address	<u>George Sourati</u> Designer's Name
<u></u> Telephone #	<u>PO Box 4458, Vineyard Haven, MA 02568</u> Address
	<u>(508) 693-9933</u> Telephone #

Type of Building: Proposed Eight Bedroom HouseLot Size 26,400± Sq. feetDwelling — No. of Bedrooms 8

Garbage Grinder ( )

Other — Type of Building \_\_\_\_\_ No. of persons \_\_\_\_\_ Showers ( ), Cafeteria ( )

Other fixtures \_\_\_\_\_

Design Flow (min. required) 880 gpd Calculated design flow 880 gpd Design flow provided 880 gpdPlan: Date February 9, 2016 Number of sheets 1 Revision Date 10-23-2017Title New Sewage Disposal SystemDescription of Soil(s) See Soils logSoil Evaluator Form No. \_\_\_\_\_ Name of Soil Evaluator G. Sourati Date of Evaluation 12-9-2015

DESCRIPTION OF REPAIRS OR ALTERATIONS \_\_\_\_\_

The undersigned agrees to install the above described Individual Sewage Disposal System in accordance with the provisions of TITLE 5 and further agrees not to place the system in operation until a Certificate of Compliance has been issued by the Board of Health.

Signed George Sourati (Agent) Date 11-2-2017

Inspections \_\_\_\_\_

FORM 1 - APPLICATION FOR DSCP

DEP APPROVED FORM 5/96

No. REV 16-46

THE COMMONWEALTH OF MASSACHUSETTS

FEE 100 -Oak Bluffs BOARD OF HEALTH  
CERTIFICATE OF COMPLIANCEDescription of Work: ☐ Individual Component(s) ☒ Complete SystemThe undersigned hereby certify that the Sewage Disposal System; Constructed ☒, Repaired ( ), Upgraded ( ), Abandoned ( )by: 150 East Chop Dr - Richard T. Olsen & Sonat 150 East Chop Drive M2 P 48

has been installed in accordance with the provisions of 310 CMR 15.00 (Title 5) and the approved design plans/as-built plans relating to application No. \_\_\_\_\_ dated \_\_\_\_\_ Approved Design Flow \_\_\_\_\_ (gpd)

Installer Richard T Olsen & Son Inc.Designer: George Sourati Inspector M. J. Lat. Date 6/8/18

The issuance of this certificate shall not be construed as a guarantee that the system will function as designed.

FORM 3 - CERTIFICATE OF COMPLIANCE

DEP APPROVED FORM 5/96

No. REV 16-46

THE COMMONWEALTH OF MASSACHUSETTS

FEE 100 -Oak Bluffs BOARD OF HEALTH

## DISPOSAL SYSTEM CONSTRUCTION PERMIT

Permission is hereby granted to Construct ☒ Repair ( ) Upgrade ( ) Abandon ( ) an individual sewage disposal system at 150 East Chop Drive as describedin the application for Disposal System Construction Permit No. REV 16-46, dated 11/3/17

Provided: Construction shall be completed within three years of the date of this permit. All local conditions must be met.

Date 11/7/17 Board of Health M. J. Lat.

FORM 2 - DSCP

DEP APPROVED FORM 5/96



THE UNIVERSITY OF CHICAGO

THE UNIVERSITY OF CHICAGO  
DIVISION OF THE PHYSICAL SCIENCES  
DEPARTMENT OF CHEMISTRY  
5408 S. UNIVERSITY AVE.  
CHICAGO, ILL. 60637

THE UNIVERSITY OF CHICAGO  
DIVISION OF THE PHYSICAL SCIENCES  
DEPARTMENT OF CHEMISTRY  
5408 S. UNIVERSITY AVE.  
CHICAGO, ILL. 60637

THE UNIVERSITY OF CHICAGO  
DIVISION OF THE PHYSICAL SCIENCES  
DEPARTMENT OF CHEMISTRY  
5408 S. UNIVERSITY AVE.  
CHICAGO, ILL. 60637

THE UNIVERSITY OF CHICAGO  
DIVISION OF THE PHYSICAL SCIENCES  
DEPARTMENT OF CHEMISTRY  
5408 S. UNIVERSITY AVE.  
CHICAGO, ILL. 60637